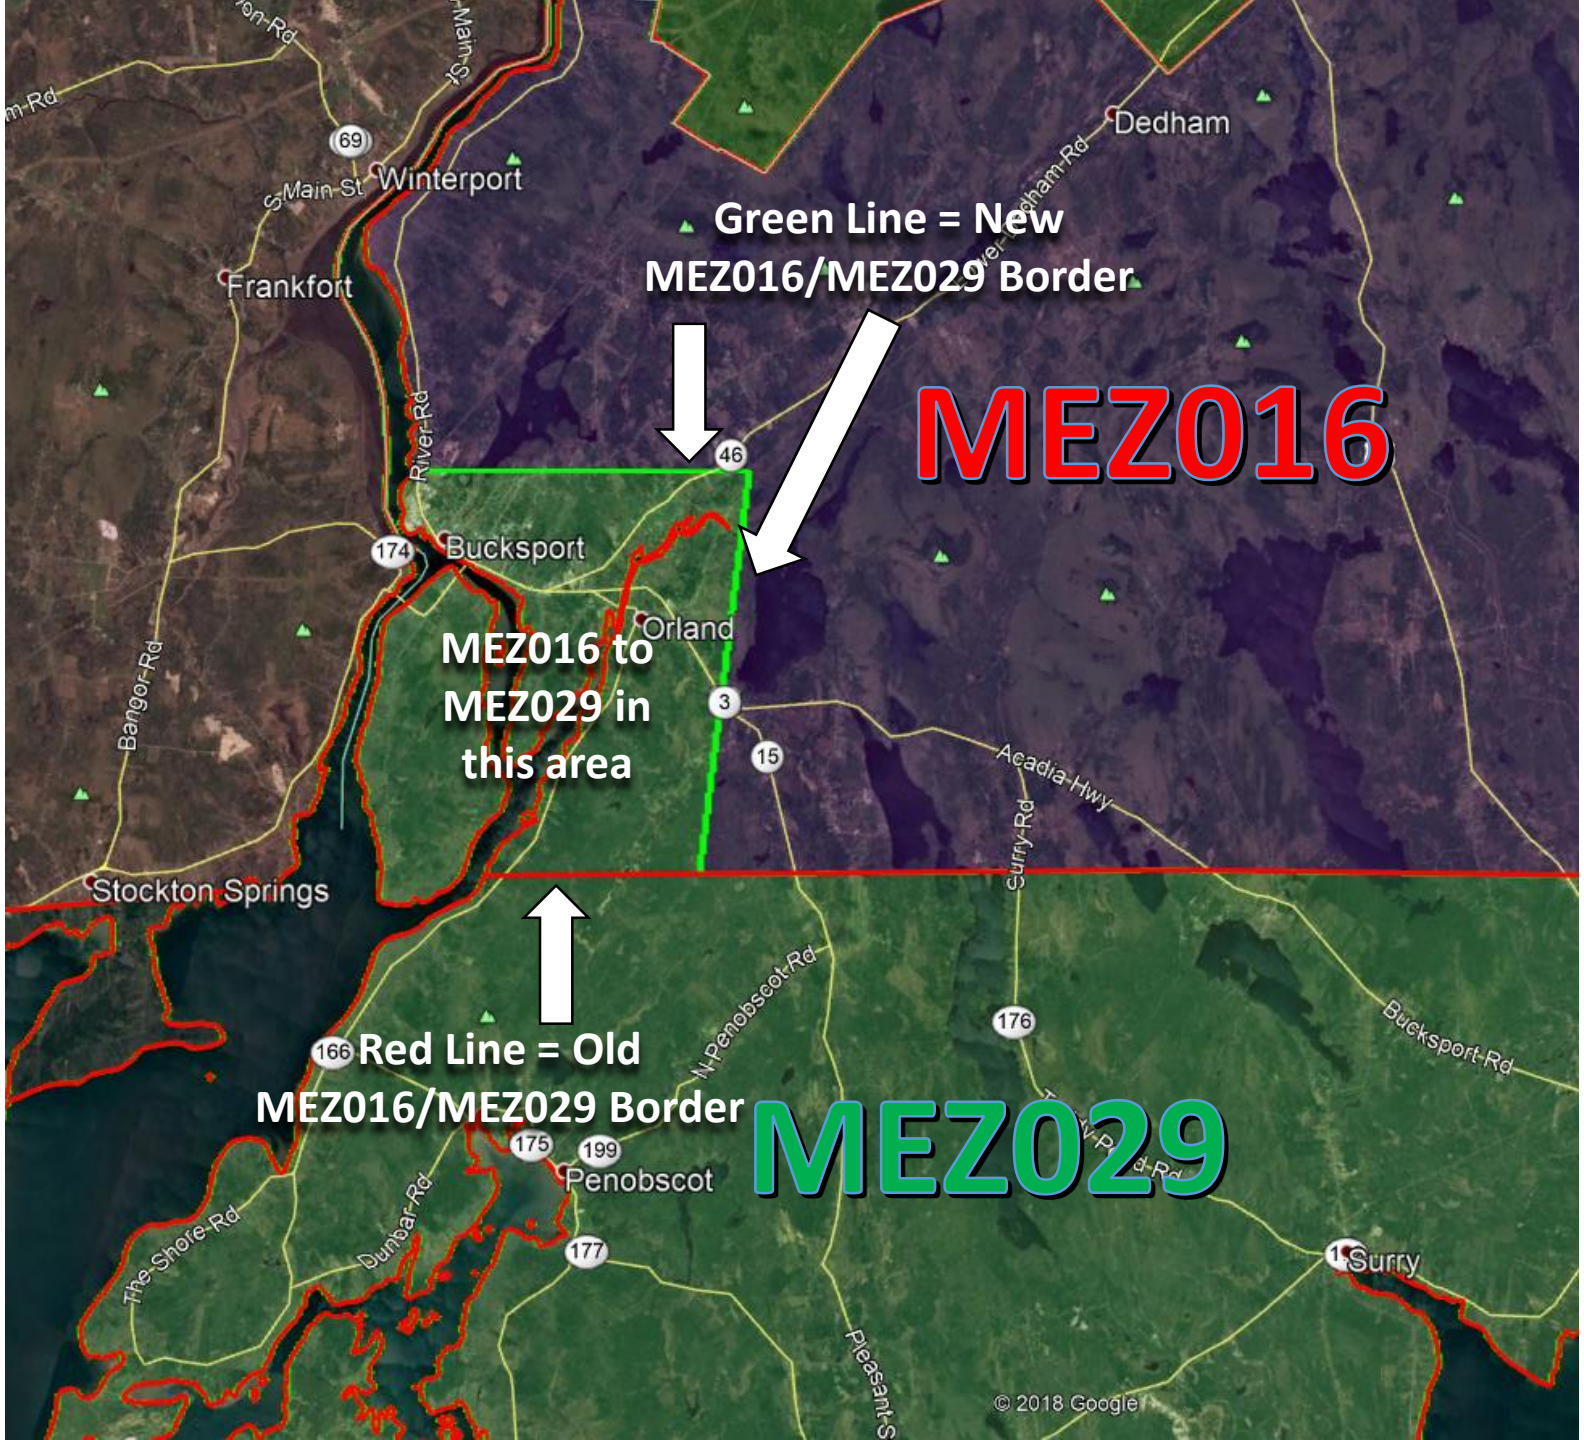
Green Line = New
MEZ016/MEZ029 Border
MEZ016
MEZ016 to
MEZ029 in
this area
Red Line = Old
MEZ016/MEZ029 Border
MEZ029
Dedham
Winterport
Frankfort
Bucksport
Orland
Stockton Springs
Penobscot
Surry
Main St
River Rd
Bangor Rd
Acadia Hwy
Surry Rd
N Penobscot Rd
Bucksport Rd
The Shore Rd
Dunbar Rd
Pleasant St
69
46
174
3
15
176
166
175
199
177
© 2018 Google

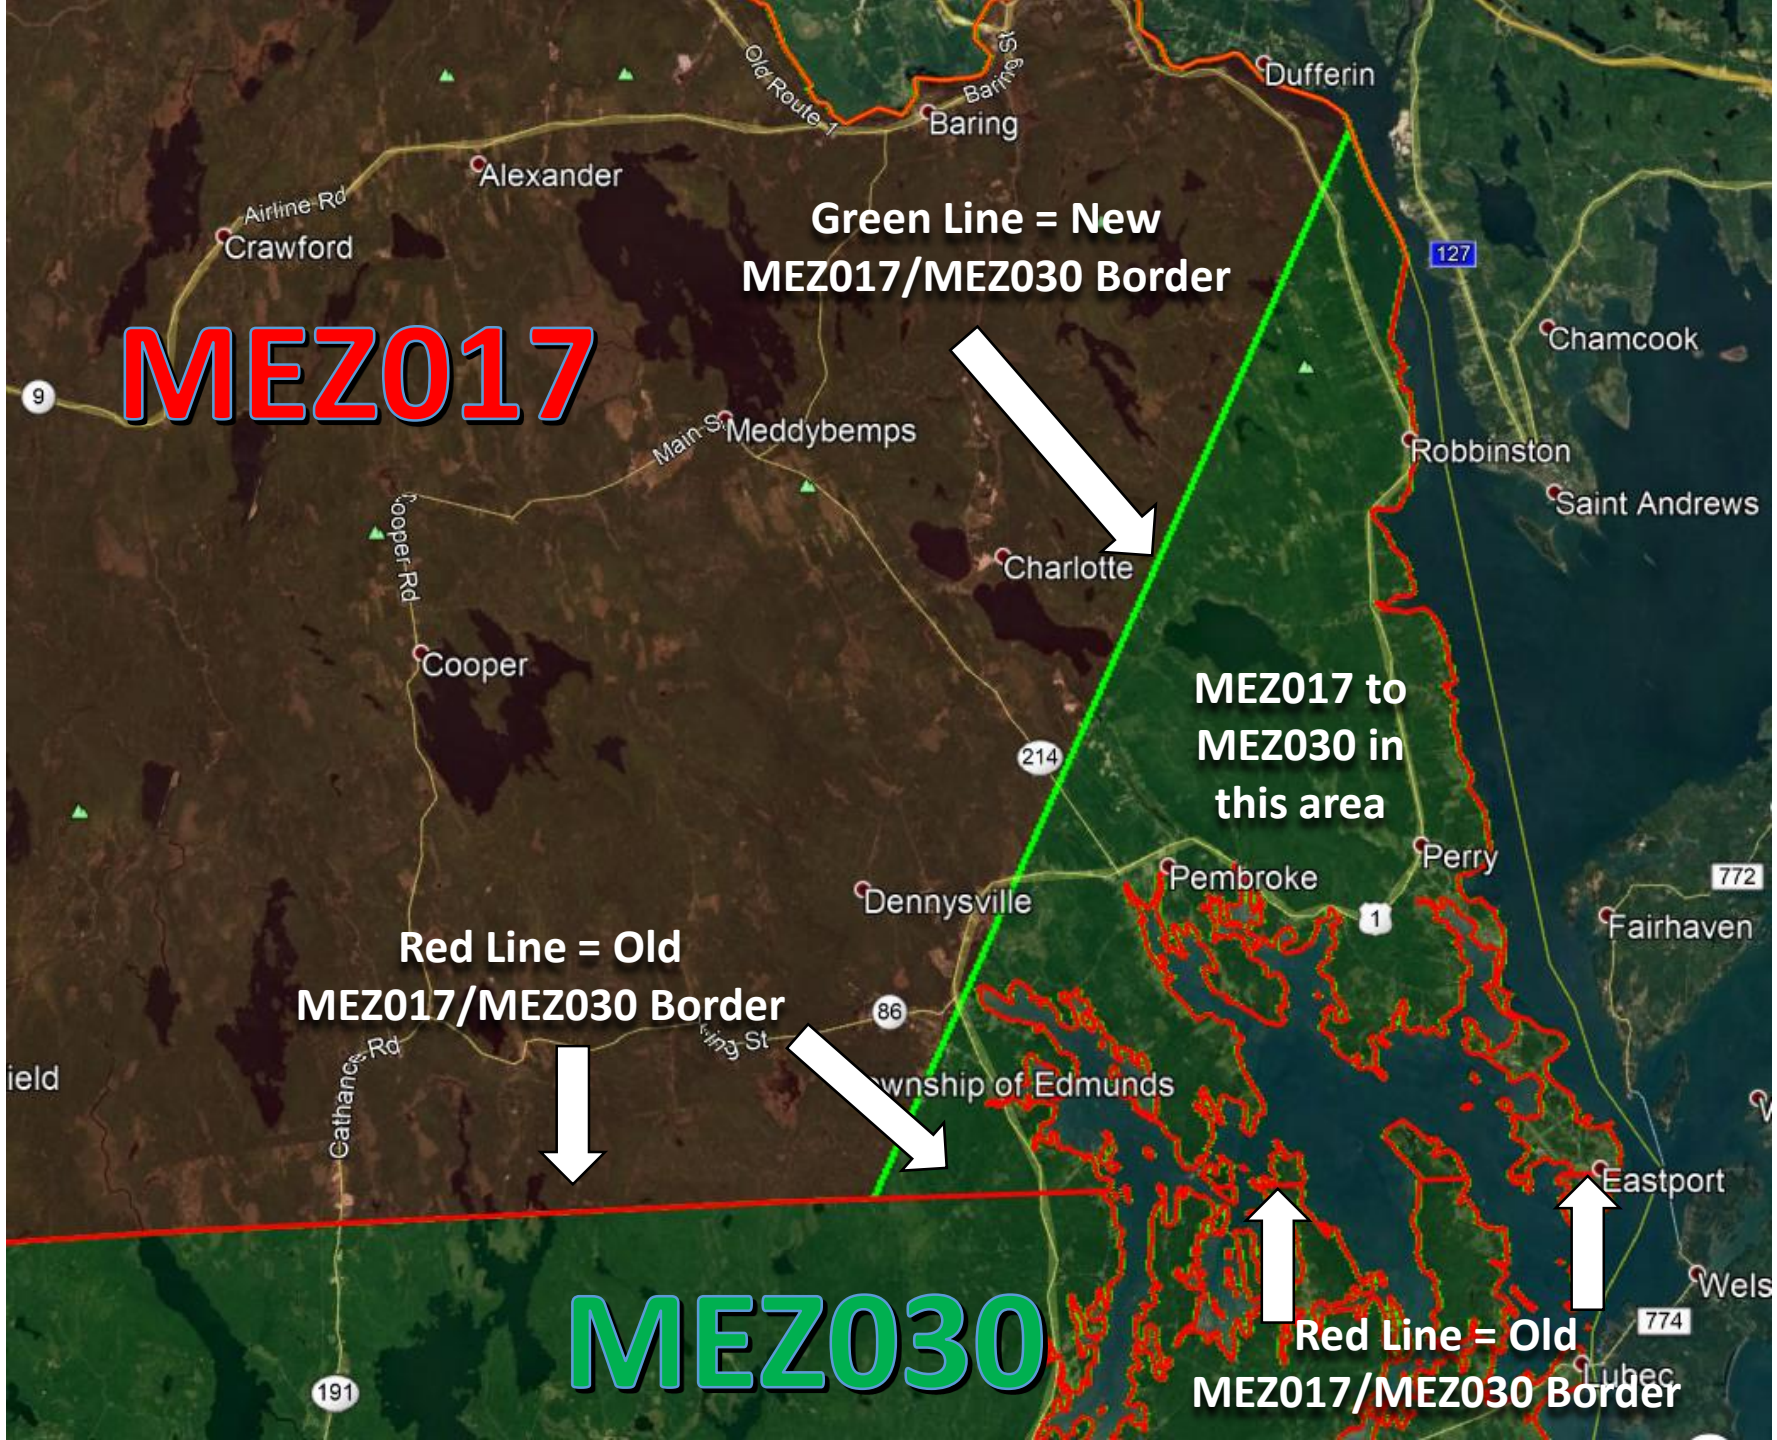
Green Line = New
MEZ017/MEZ030 Border
MEZ017
MEZ017 to
MEZ030 in
this area
Red Line = Old
MEZ017/MEZ030 Border
MEZ030
Red Line = Old
MEZ017/MEZ030 Border
Dufferin
Baring
Old Route 1
Alexander
Airline Rd
Crawford
Meddybemps
Main St
Cooper Rd
Cooper
Charlotte
Chamcook
Robbinston
Saint Andrews
Perry
Pembroke
Dennysville
Fairhaven
Cathance Rd
Eastport
Wels
Lubec
127
9
214
1
772
86
774
191